


1 DEMOLITION PLAN - FOURTH FLOOR #406-AR-002
1/100

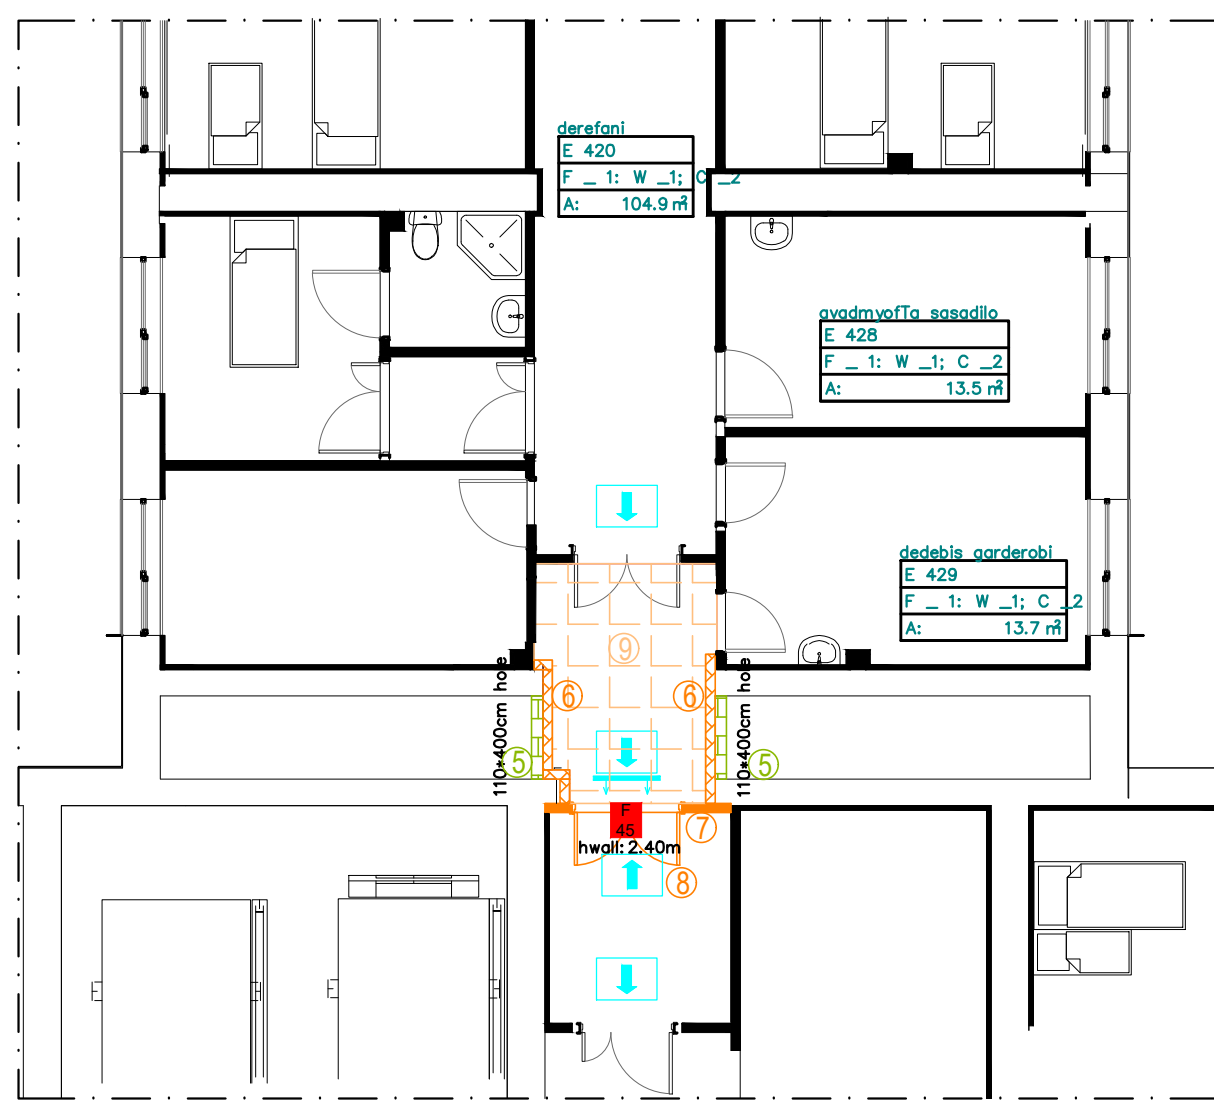


2 NEW CONSTRUCTION PLAN - FOURTH FLOOR #406-AR-002
1/100

- Demolition of grid suspended ceiling- total 7.1m2
- Demolition of equipment on the ceiling
 - 2 60*60 led lighting fixture
 - 1 smoke dedector
 - 1 sprinkler
 - 1 45*25 culvert
 - 1 Ø20 diffuser
 - 1 40*20 galvanized duct
 - 1 Ø30 flexible duct(4m)
 - 1 Ø200 flexible duct(4m)
- Demolition of equipment on the wall
 - 1 Oxygen-vacuum panel(20*30cm)
- Demolition of plasterboard walls in front of the shafts.(213*240cm and 197*240cm)
- Closing the hole in front of the shaft by bins wall 2X (110*400cm)
- Construction of new EI120 shaft walls-2*25mm manufactured from one side-
- Construction of new EI60 compartment wall-2*12.5mm manufactured from both sides, see wall detail. (216*267cm)
- Provide a new double-leaf, EI45 fire door (120*210cm) to the compartment wall.
- Mounting new grid suspended ceiling- total 7.1m2
- Reassembling of equipment on the ceiling
- Install fire dampers on ducts (2m)
- Firestopping around the cavities of the ducts.
- Repairing of vinly tiling on the floor of the parts which are damaged while demolishing the walls.


LEGEND AND MATERIAL LIST	
SYMBOL	DESCRIPTION
	TO BE DEMOLISHED 60*60 GRID SUSPENDED CEILING
	TO BE MOUNTED 60*60 GRID SUSPENDED CEILING
	TO BE DEMOLISHED PVC HYGIENIC SUSPENDED CEILING
	TO BE MOUNTED PVC HYGIENIC SUSPENDED CEILING
	TO BE DEMOLISHED PLASTERBOARD SUSPENDED CEILING
	TO BE MOUNTED PLASTERBOARD SUSPENDED CEILING
	TO BE CLOSED HOLE BY BMS WALL
	TO BE DEMOLISHED EXISTING PLASTERBOARD WALL
	TO BE DEMOLISHED EXISTING CERAMIC TILE
	TO BE CONSTRUCTED PLASTERBOARD WALL WITHOUT FIRE RATING
	TO BE CONSTRUCTED CERAMIC TILE
	TO BE CONSTRUCTED COMPARTMENT WALL FOR FIRE SEPARATION EI60- 2x12,5 mm /from both sides
	TO BE CONSTRUCTED SHAFT WALL FOR FIRE SEPARATION EI120 - Shaft Wall 2x25 mm Flameboard/from one side
	TO BE CONSTRUCTED WALL FOR FIRE SEPARATION EI120 - 2x15 mm/from both sides
	TO BE CONSTRUCTED WALL FOR FIRE SEPARATION EI60 - 2x15 mm Plasterboard/from one side
	TO BE CONSTRUCTED HALL WALL FOR FIRE SEPARATION EI60 - One Layer
	TO BE DEMOLISHED EXISTING DOOR
	TO BE MOUNTED NEW FIRE DOOR
	TO BE REMOUNTED EXISTING DOOR



3 PHOTOGRAPHS OF CURRENT SITUATION -FOURTH FLOOR #406-AR-002

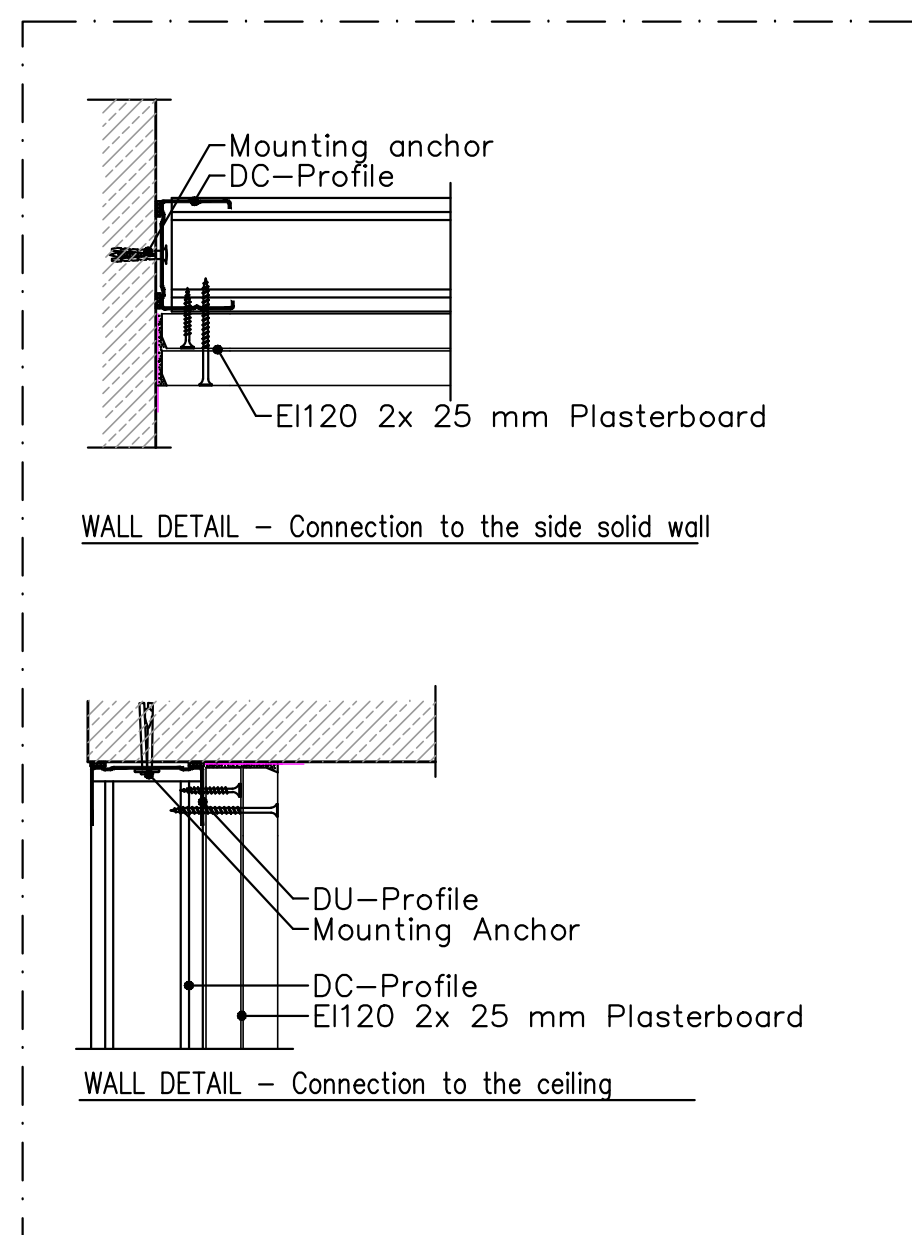

4 SHAFT WALL DETAIL FOR FIRE SEPARATION EI120/from one side

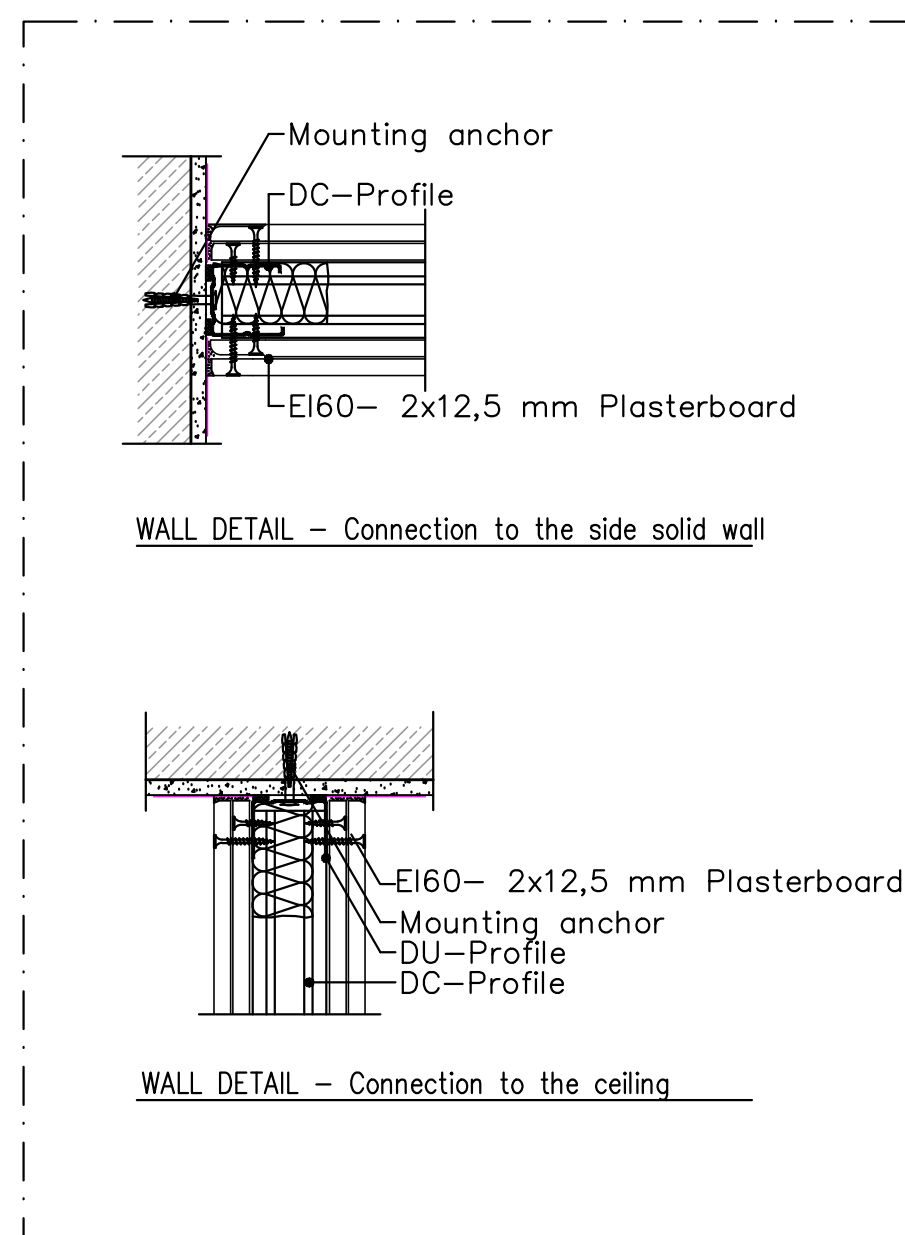

5 COMPARTMENT WALL DETAIL FOR FIRE SEPARATION EI60/from both sides

<input checked="" type="checkbox"/> FOR SYSTEM APPROVAL <input type="checkbox"/> FOR TENDER <input type="checkbox"/> FOR INSTALLATION <input type="checkbox"/> AS BUILT	
KEY PLAN	
For System Approval	
Date	Explanation
CLIENT 	
DESIGNER TASARIM, DANIŞMANLIK VE EĞİTİM HİZMETLERİ LTD.ŞTİ. Cetin EMEC Bulvarı 2. Cad. No : 37/4 A. ÖVEÇLER - 06460 ANKARA / TURKEY Tel : +90-312-472 62 88 Faks : +90-312-472 62 89 e-posta: info@karina.gen.tr	
TECH. CONSULTANCY	: KARİNA
SYSTEM DESIGN	: KARİNA
MATERIAL SUPPLY	: -
INSTALLATION	: -
APPROVAL	: -
DATE	: 08.11.2020
SCALE	: 1/100
DRAWING NO : EVEK-SNS-KAR-406-AR-002	
FILE NAME : C:\EVEK-SNS-KAR-404-406-407-AR*	
REV. : *	