


① DEMOLITION PLAN - FOURTH FLOOR #405-AR-001
1/100




② NEW CONSTRUCTION PLAN - FOURTH FLOOR #405-AR-001
1/100


1. Demolition of the door of the electrical room(90x210cm)
2. Provide a new E190 door(90x210cm)
3. Demolition of the door of the UPS room(90x210cm)
4. Provide a new E190 door for the UPS room(90x210cm)
5. Apply plaster to the walls of electrical room and UPS room from the outside of the rooms. (650x250cm,520x250cm,310x250cm)

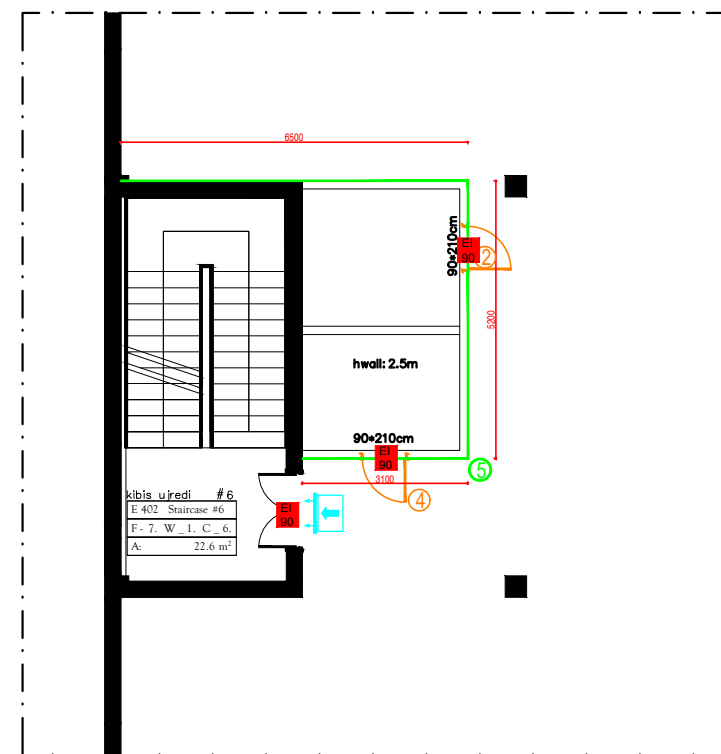

③ PHOTOGRAPHS OF CURRENT SITUATION -FOURTH FLOOR #405-AR-001

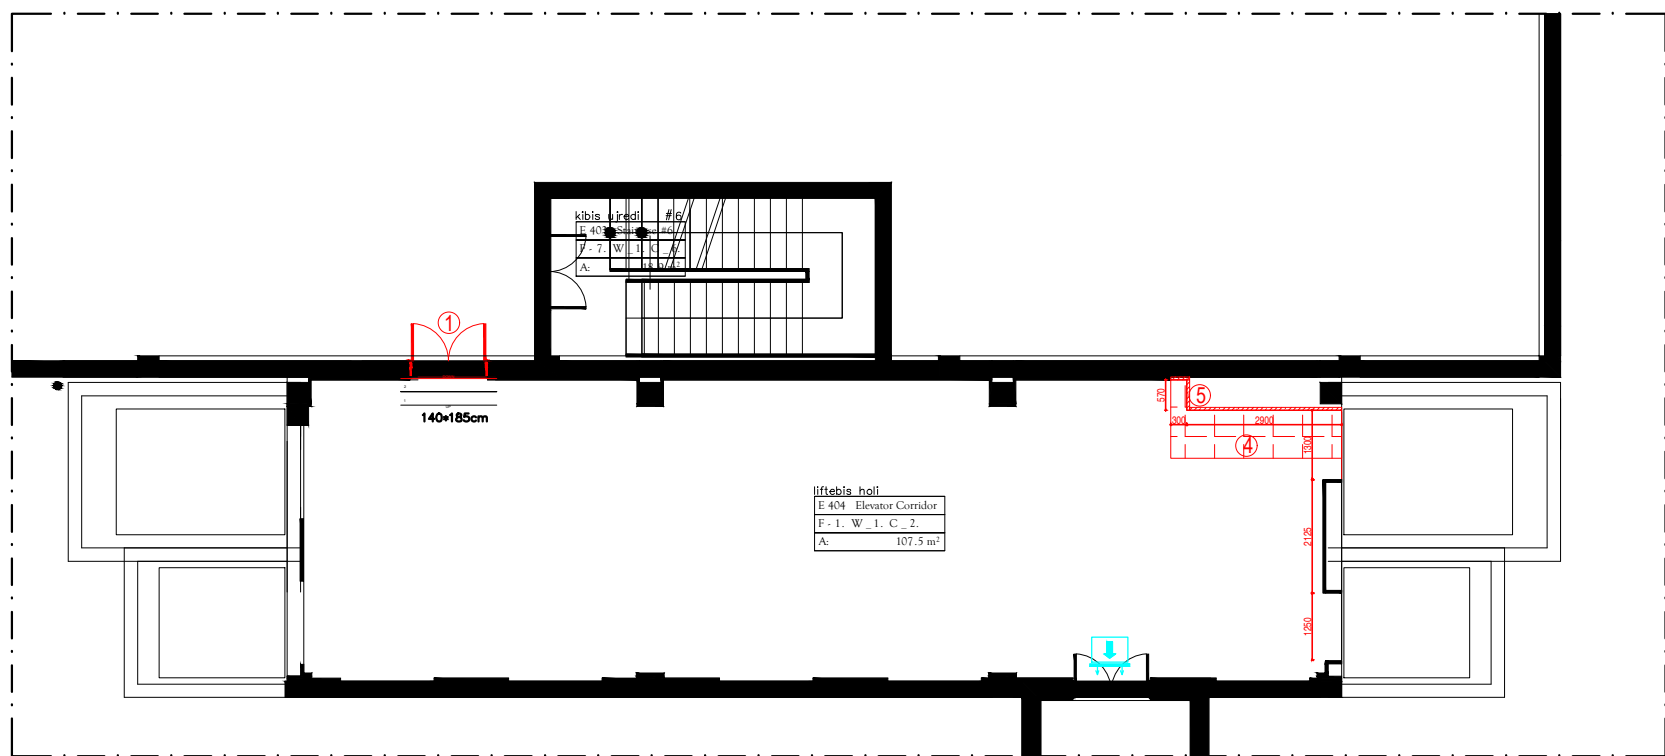

① DEMOLITION PLAN - FOURTH FLOOR #405-AR-002
1/100

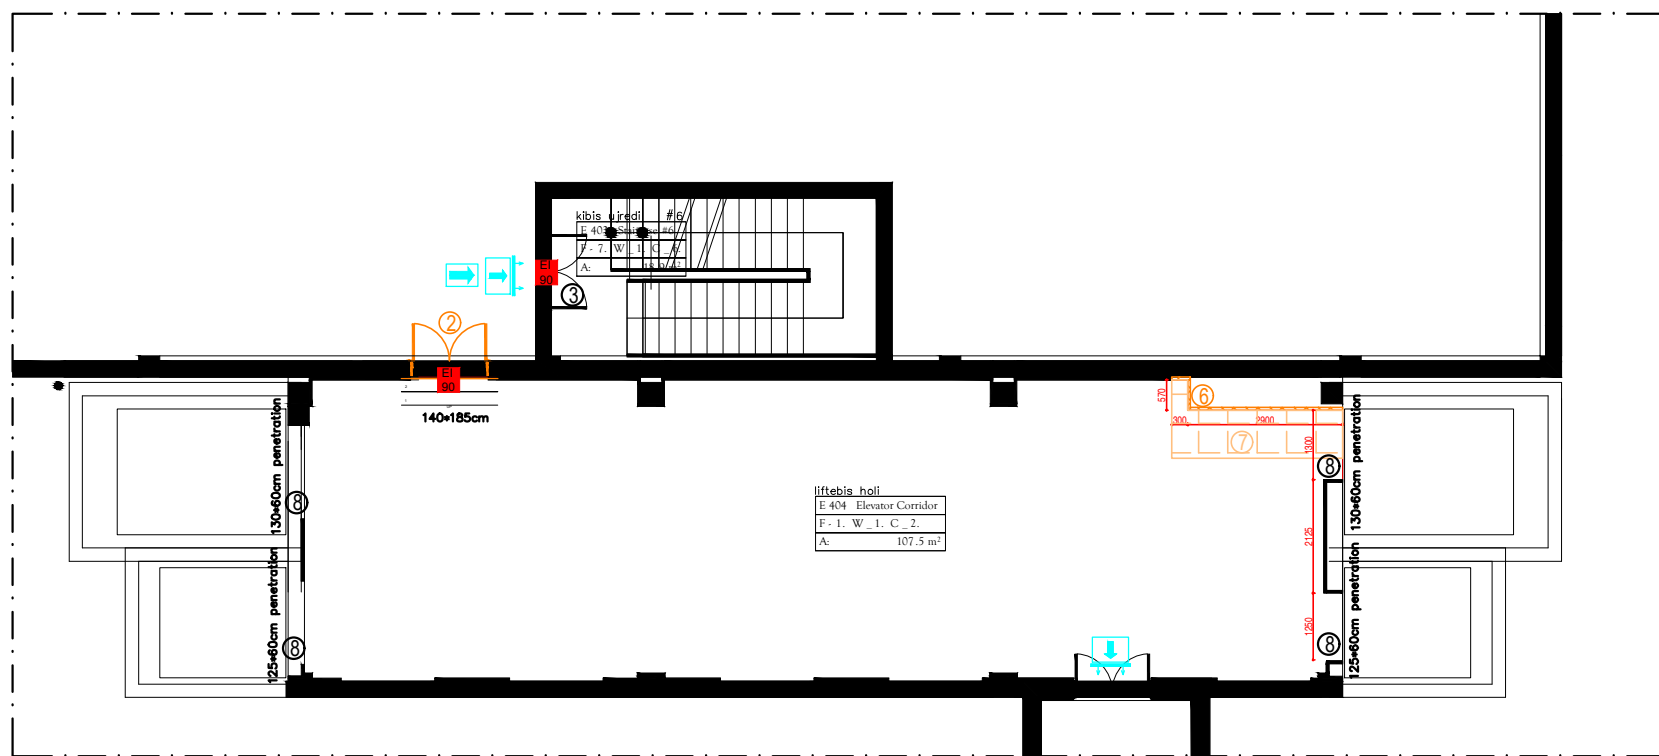

② NEW CONSTRUCTION PLAN - FOURTH FLOOR #405-AR-002
1/100

1. Demolition of the door which opens to the elevator hall (140x185cm)
2. Provide a new E190 door (140x185cm)
3. Provide a door opener for the fire staircase door
4. Demolition of grid suspended ceiling at the corner part of the elevator-3.1m2
5. Demolition of the plasterboards in front of the shaft (30x300cm,57x300cm,290x300cm)
6. Mounting of two layers of 25mm plasterboards to construct E120 wall
7. Mounting of grid suspended ceiling-3.1m2
8. Apply fire stopping to the entrances of four elevators by filling with rock wool (150kg/m3) (2x130x60cm,2x125x60cm)



③ PHOTOGRAPHS OF CURRENT SITUATION -FOURTH FLOOR #405-AR-002

LEGEND AND MATERIAL LIST	
SYMBOL	DESCRIPTION
	TO BE DEMOLISHED 60x60 GRID SUSPENDED CEILING
	TO BE MOUNTED 60x60 GRID SUSPENDED CEILING
	TO BE DEMOLISHED PVC HYDROGEN SUSPENDED CEILING
	TO BE MOUNTED PVC HYDROGEN SUSPENDED CEILING
	TO BE DEMOLISHED PLASTERBOARDS SUSPENDED CEILING
	TO BE MOUNTED PLASTERBOARDS SUSPENDED CEILING
	TO BE CLOSED HOLE BY IRMS WALL
	TO BE APPLIED FIRE STOPPING AT THE FLOOR LEVEL WITH ADDITIONAL SUPPORTING CONSTRUCTION
	TO BE DEMOLISHED EXISTING PLASTERBOARD WALL
	TO BE DEMOLISHED EXISTING GLASS PARTITION WALL
	TO BE DEMOLISHED EXISTING CERAMIC TILE
	TO BE CONSTRUCTED PLASTERBOARD WALL WITHOUT FIRE RATING
	TO BE CONSTRUCTED CERAMIC TILE
	TO BE CONSTRUCTED COMPARTMENT WALL FOR FIRE SEPARATION E30-2x12.5 mm /from both sides
	TO BE CONSTRUCTED SHAFT WALL FOR FIRE SEPARATION E120 - Shaft Wall 2x25 mm Plasterboard/From one side
	TO BE CONSTRUCTED WALL FOR FIRE SEPARATION E120 - 2x15 mm/From both sides
	TO BE CONSTRUCTED WALL FOR FIRE SEPARATION E30 - 2x15 mm Plasterboard/From one side
	TO BE CONSTRUCTED PLASTERBOARD WALL -ABOVE THE EXISTING WALL
	TO BE CONSTRUCTED PLASTERBOARD WALL FOR FIRE SEPARATION E30 - One Layer
	TO BE CONSTRUCTED 25mm PLASTERBOARD WALL FOR FIRE SEPARATION E120- One Layer
	TO BE CONSTRUCTED 15mm PLASTERBOARD WALL FOR FIRE SEPARATION E120- One Layer
	TO BE APPLIED PLASTER
	TO BE DEMOLISHED EXISTING DOOR
	TO BE MOUNTED NEW FIRE DOOR
	TO BE REMOUNTED EXISTING DOOR

<input type="checkbox"/> FOR SYSTEM APPROVAL <input type="checkbox"/> FOR TENDER <input type="checkbox"/> FOR INSTALLATION <input type="checkbox"/> AS BUILT		
 KEY PLAN		
Date	For System Approval Explanation	
CLIENT	EYEX GEORGIA HEALTHCARE GROUP 40 Vahit Dedeoğlu Ave Tbilisi - GEORGIA Tel: +995 322 35 05 05	
DESIGNER	KARINA TASARIM, DANIŞMANLIK VE EĞİTİM HİZMETLERİ LTD.ŞTİ. Ceth EMEC Bulvarı 2. Cad. No : 37/4 A. ÖZELER - 06460 ANKARA / TÜRKİYE Tel : +90-312-472 62 88 Faks : +90-312-472 62 89 e-posta: info@karina.gen.tr	
TECH. CONSULTANCY : KARINA	FIRE & LIFE SAFETY-05 IMPROVEMENT OF FIRE & SMOKE CONFINEMENT FEATURES DRAWINGS	
SYSTEM DESIGN : KARINA		
MATERIAL SUPPLY : -		
INSTALLATION : -		
APPROVAL : -	DRAWING NO : EVEX-DEKA-KAR-405-AR-001-002	REV. 00
DATE : 06.03.2021	CAD	/
SCALE : 1/100	FILE NAME : C:\EVEX-DEKA-KAR-401-402-403-404-405-AR	