


① DEMOLITION PLAN - SECOND FLOOR #201-AR-001
1/100

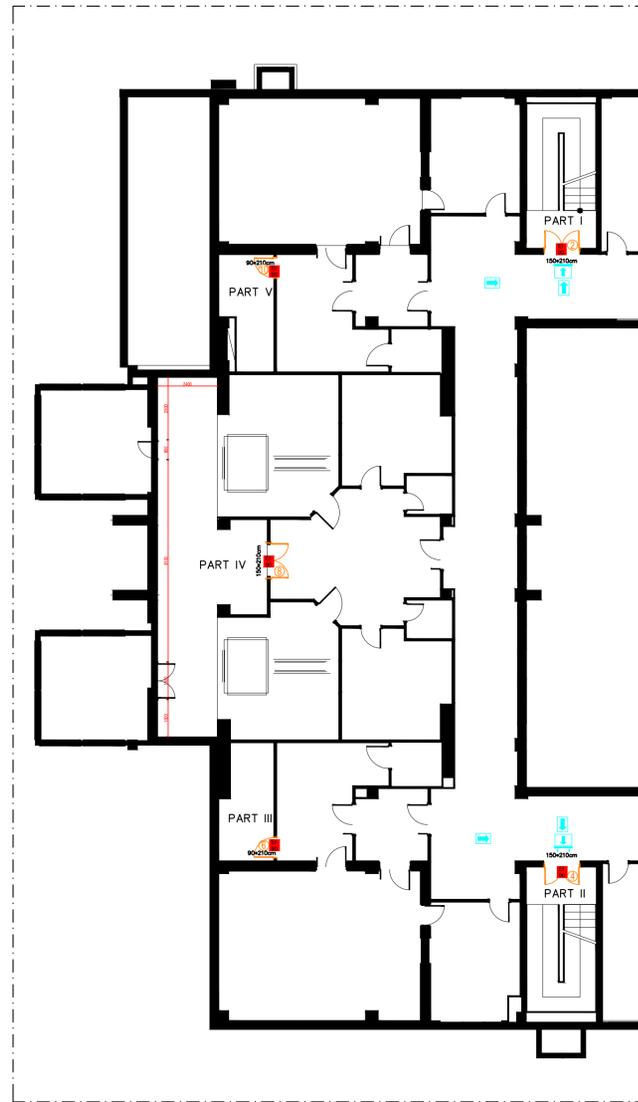

② NEW CONSTRUCTION PLAN - SECOND FLOOR #201-AR-001
1/100


- PART I**
- Demolition of the existing door of the fire staircase (150x210cm)
 - Provide a new double-leaf EI90 door for the fire staircase (150x210cm)
- PART II**
- Demolition of the existing door of the fire staircase (150x210cm)
 - Provide a new double-leaf EI90 door for the fire staircase (150x210cm)
- PART III**
- Demolition of the existing door of the CT room (90x210cm)
 - Provide a new one-leaf EI90 door for the CT room (90x210cm)
- PART IV**
- Demolition of the existing door of the technical room of MRI (150x210cm)
 - Provide a new double-leaf EI90 door for the technical room of MRI (150x210cm)
- PART V**
- Demolition of the existing door of the CT room (90x210cm)
 - Provide a new one-leaf EI90 door for the CT room (90x210cm)

LEGEND AND MATERIAL LIST	
SYMBOL	DESCRIPTION
[Red dashed line]	TO BE DEMOLISHED 60x60 GRID SUSPENDED CEILING
[Red dashed line]	TO BE MOUNTED 60x60 GRID SUSPENDED CEILING
[Red dashed line]	TO BE DEMOLISHED PVC HYDROIC SUSPENDED CEILING
[Red dashed line]	TO BE MOUNTED PVC HYDROIC SUSPENDED CEILING
[Red dashed line]	TO BE DEMOLISHED PLASTERBOARD SUSPENDED CEILING
[Red dashed line]	TO BE MOUNTED PLASTERBOARD SUSPENDED CEILING
[Red dashed line]	TO BE CLOSED HOLE BY IRIS WALL
[Red dashed line]	TO BE APPLIED FIRE STOPPING AT THE FLOOR LEVEL WITH ADDITIONAL SUPPORTING CONSTRUCTION
[Red dashed line]	TO BE DEMOLISHED EXISTING PLASTERBOARD WALL
[Red dashed line]	TO BE DEMOLISHED EXISTING GLASS PARTITION WALL
[Red dashed line]	TO BE DEMOLISHED EXISTING CERAMIC TILE
[Red dashed line]	TO BE CONSTRUCTED PLASTERBOARD WALL WITHOUT FIRE RATING
[Red dashed line]	TO BE CONSTRUCTED CERAMIC TILE
[Red dashed line]	TO BE CONSTRUCTED COMPARTMENT WALL FOR FIRE SEPARATION E90 - 2x12.5 mm / from both sides
[Red dashed line]	TO BE CONSTRUCTED SHUTT WALL FOR FIRE SEPARATION E120 - Shell Wall 2x25 mm Plasterboard / from one side
[Red dashed line]	TO BE CONSTRUCTED WALL FOR FIRE SEPARATION E120 - 2x15 mm / from both sides
[Red dashed line]	TO BE CONSTRUCTED WALL FOR FIRE SEPARATION E90 - 2x15 mm Plasterboard / from one side
[Red dashed line]	TO BE CONSTRUCTED PLASTERBOARD WALL - ABOVE THE EXISTING WALL
[Red dashed line]	TO BE CONSTRUCTED PLASTERBOARD WALL FOR FIRE SEPARATION E90 - One Layer
[Red dashed line]	TO BE CONSTRUCTED 25MM PLASTERBOARD WALL FOR FIRE SEPARATION E120- One Layer
[Red dashed line]	TO BE CONSTRUCTED 15MM PLASTERBOARD WALL FOR FIRE SEPARATION E120- One Layer
[Red dashed line]	TO BE APPLIED PLASTER
[Red dashed line]	TO BE DEMOLISHED EXISTING DOOR
[Red dashed line]	TO BE MOUNTED NEW FIRE DOOR
[Red dashed line]	TO BE REMAINDERS EXISTING DOOR



③ PHOTOGRAPHS OF CURRENT SITUATION -SECOND FLOOR #201-AR-001

- [Red dashed line] FOR SYSTEM APPROVAL
- [Red dashed line] FOR TENDER
- [Red dashed line] FOR INSTALLATION
- [Red dashed line] AS BUILT

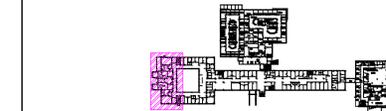

Date	For System Approval	Explanation

CLIENT: **EVEX HOSPITALS** EVEX GEORGIA HEALTHCARE GROUP
40 Vahdi Pinaroğlu Ave
Tbilisi - GEORGIA
Tel: +995 322 35 05 05

DESIGNER: **KARİNA** TASARIM, DANIŞMANLIK VE EĞİTİM HİZMETLERİ LTD.ŞTİ.
Caddesi EMEC Bulvarı 2. Cad. No : 37/4
A. ÖZGÜLER - 06460 ANKARA / TÜRKİYE
Tel : +90-312-472 62 88 Faks : +90-312-472 62 89 e-posta: info@karina.gen.tr

TECH. CONSULTANCY : KARİNA	FIRE & LIFE SAFETY-05 IMPROVEMENT OF FIRE & SMOKE CONFINEMENT FEATURES DRAWINGS
SYSTEM DESIGN : KARİNA	
MATERIAL SUPPLY : -	
INSTALLATION : -	
APPROVAL : -	
DATE : 06.03.2021	DRAWING NO : EVEX-DEKA-KAR-201-AR-001
SCALE : 1/100	FILE NAME : C:\EVEX-DEKA-KAR-201-202-203-204-205-AR