


① DEMOLITION PLAN - FIRST FLOOR #104-AR-001
1/100

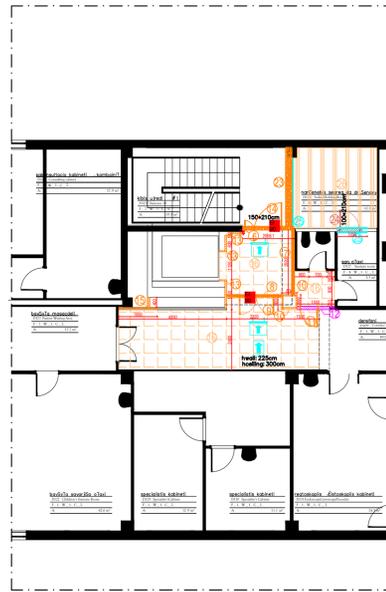

② NEW CONSTRUCTION PLAN - FIRST FLOOR #104-AR-001
1/100

PART I

- Demolition of the equipment on the ceiling of elevator hall and the corridor
 - 2 fire button
 - 3 camera
 - 1 45x25cm culvert with plenum box
 - 1 45x25cm culvert
 - 4 60x60cm led lighting fixture
 - 1 diffuser
 - 2m flexible duct
- Demolition of grid suspended ceiling-29.9m²
- Demolition of the existing door of fire staircase (150x210cm)
- Demolition of the equipment on the walls
 - 1 electric switch
 - 1 fire button
 - 1 elevator control panel
 - 1 fire extinguisher
- Demolition of plasterboard walls in front of the elevator and corridor.
(120x225cm,30x225cm,120x15cm,30x225cm,62x225cm,22x225cm,50x225cm,10x225cm,50x225cm,150x15cm,10x225cm,150x225cm,46x225cm,60x225cm,60x225cm,150x225cm,155x225cm)
- Construct EI120 Wall
- Mounting of two layers of 15mm plasterboards from both sides to the entrance of fire staircase (205x300cm)
- Construct a new EI120 wall between the column and the wall of the fire staircase by mounting of two layers of 25mm plasterboards from one side over the existing wall (259x300cm)
- Construct a new EI120 wall between the column and the elevator wall to create a separate hall by mounting of two layers of 15mm plasterboards from both sides (220x300cm)
- Provide a new double-leaf EI90 door for elevator hall (150x210cm)
- Mounting of two layers of 25mm plasterboards from one side to the column (4x60x300)
- Provide a new one-leaf door (300x210cm) to the entrance of the hall of WC from the corridor
- Mounting plasterboards without fire rating to the entrance of WC from the corridor(2x150x300cm)
- Mounting of two layers of 25mm plasterboards from one side to walls in front of the elevator (120x300cm,30x300cm,120x90cm,30x300cm,62x300cm,22x300cm,50x300cm,10x300cm)
- Provide a new double-leaf EI90 door for fire staircase (one leaf is 20cm, one leaf 115cm, height is 210cm).
- Construct a new EI120 wall by mounting of two layers of 25mm plasterboards from one side to shaft from the corridor side(40x300cm,155x300cm)
- Mounting of grid suspended ceiling-29.9m²
- Reassemble of the equipments on the ceiling and the wall, provide a fire damper on the duct

PART II

- Demolition of the existing door of the room located at the staircase(100x210cm)
- Demolition of plasterboard of the wall between staircase and holding room(328x225cm)


PART III

- Demolition of the equipment on the ceiling
- Demolition of PVC hygienic ceiling-10.8m²
- Demolition of ceramic tiling on the wall (328x225cm, 2x120x225cm)
- Construct a new EI120 wall between the fire staircase and the room by mounting two layers of 15mm plasterboards from both sides(328x225cm)
- Move the existing door changing its location by giving an entrance from sanitary room (100x210cm)
- Ceramic tiling instead of the demolished ones (328x225cm, 2x120x225cm)
- Mounting of PVC hygienic ceiling-10.8m²
- Reassemble of the equipments on the ceiling and the wall

LEGEND AND MATERIAL LIST	
SYMBOL	DESCRIPTION
[Symbol]	TO BE DEMOLISHED 60x60 GRID SUSPENDED CEILING
[Symbol]	TO BE MOUNTED 60x60 GRID SUSPENDED CEILING
[Symbol]	TO BE DEMOLISHED PVC HYGIENIC SUSPENDED CEILING
[Symbol]	TO BE MOUNTED PVC HYGIENIC SUSPENDED CEILING
[Symbol]	TO BE DEMOLISHED PLASTERBOARD SUSPENDED CEILING
[Symbol]	TO BE MOUNTED PLASTERBOARD SUSPENDED CEILING
[Symbol]	TO BE CLOSED HOLE BY IRG WALL
[Symbol]	TO BE APPLIED FIRE STOPPING AT THE FLOOR LEVEL WITH ADDITIONAL SUPPORTING CONSTRUCTION
[Symbol]	TO BE DEMOLISHED EXISTING PLASTERBOARD WALL
[Symbol]	TO BE DEMOLISHED EXISTING GLASS PARTITION WALL
[Symbol]	TO BE DEMOLISHED EXISTING CERAMIC TILE
[Symbol]	TO BE DEMOLISHED PLASTERBOARD WALL WITHOUT FIRE RATING
[Symbol]	TO BE DEMOLISHED CERAMIC TILE
[Symbol]	TO BE CONSTRUCTED COMPARTMENT WALL FOR FIRE SEPARATION EI90- 2x12.5 mm Plasterboard/From both sides
[Symbol]	TO BE CONSTRUCTED SHAFT WALL FOR FIRE SEPARATION EI120 - Shaft Wall 2x25 mm Plasterboard/From one side
[Symbol]	TO BE CONSTRUCTED WALL FOR FIRE SEPARATION EI120 - 2x15 mm/From both sides
[Symbol]	TO BE CONSTRUCTED WALL FOR FIRE SEPARATION EI90 - 2x15 mm Plasterboard/From one side
[Symbol]	TO BE CONSTRUCTED PLASTERBOARD WALL ABOVE THE EXISTING WALL
[Symbol]	TO BE CONSTRUCTED PLASTERBOARD WALL FOR FIRE SEPARATION EI90 - One Layer
[Symbol]	TO BE CONSTRUCTED 25MM PLASTERBOARD WALL FOR FIRE SEPARATION EI120- One Layer
[Symbol]	TO BE CONSTRUCTED 15MM PLASTERBOARD WALL FOR FIRE SEPARATION EI120- One Layer
[Symbol]	TO BE APPLIED PLASTER
[Symbol]	TO BE DEMOLISHED EXISTING DOOR
[Symbol]	TO BE MOUNTED NEW FIRE DOOR
[Symbol]	TO BE REMOVED EXISTING DOOR



③ PHOTOGRAPHS OF CURRENT SITUATION - FIRST FLOOR #104-AR-001

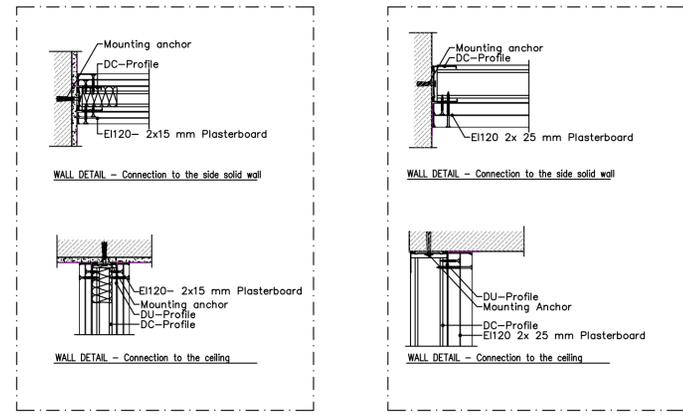

④ WALL DETAIL FOR FIRE SEPARATION EI120/From both sides
⑤ WALL DETAIL FOR FIRE SEPARATION EI120/From one side

<input type="checkbox"/> FOR SYSTEM APPROVAL <input type="checkbox"/> FOR TENDER <input type="checkbox"/> FOR INSTALLATION <input type="checkbox"/> AS BUILT	
<p>KEY PLAN</p>	
Date	Explanation
CLIENT: EVEX HOSPITALS EVEX GEORGIA HEALTHCARE GROUP 40 Vahit Pinarova Ave Tbilisi - GEORGIA Tel: +995 322 35 05 05	
DESIGNER: KARINA TASARIM, DANIŞMANLIK VE EĞİTİM HİZMETLERİ LTD.ŞTİ. Cedit EMEC Binası 2. Cad. No : 37/4 A. ÖZGELER - 06460 ANKARA / TÜRKİYE Tel : +90-312-472 62 88 Fax : +90-312-472 62 89 e-posta: info@karina.com.tr	
TECH. CONSULTANCY	: KARINA
SYSTEM DESIGN	: KARINA
MATERIAL SUPPLY	: -
INSTALLATION	: -
APPROVAL	: -
DATE	: 06.03.2021
SCALE	: 1/100
DRAWING NO: EVEX-DEKA-KAR-104-AR-001 FILE NAME: C:\EVEX-DEKA-KAR-101-102-103-104-105*	

ORIGINAL DRAWING SIZE : A0 841mm x 1189 mm