


① DEMOLITION PLAN – FIRST FLOOR MEDICAL SUPPLY ROOM #101-AR-001
1/100




② NEW CONSTRUCTION PLAN – FIRST FLOOR MEDICAL SUPPLY ROOM #101-AR-001
1/100


1. Demolition of the equipment on the ceiling
2. Demolition of grid suspended ceiling-263.9m²
3. There already exists one layer of plasterboard, but it does not continue up to the ceiling, so 10cm height space between the existing plasterboard wall and ceiling will be closed by mounting one layer of plasterboard above the existing one (559*10cm,190*10cm,176*10cm,1850*10cm,542*10cm,176*10cm,666*10cm)
4. Demolition of the existing door of AHU room(94*210cm)
5. Apply fire stopping to the hole above the door(94*20cm)
6. Mounting one layer of 15mm EI60 plasterboard to the wall of AHU room within the doo from the room(880*270cm)
7. Provide a new E130 door for AHU room (94*210cm)
8. There already exists one layer of plasterboard, but it does not continue up to the ceiling, so 60cm height space between the existing plasterboard wall and ceiling will be closed by mounting one layer of plasterboard above the existing one (495*60cm,199*60cm,377*60cm)
9. Change the door lock of two doors
10. Provide a new double-leaf door (126*210cm)
11. Mounting of grid suspended ceiling-10.8m²
12. Reassemble of the equipments on the ceiling-263.9m²

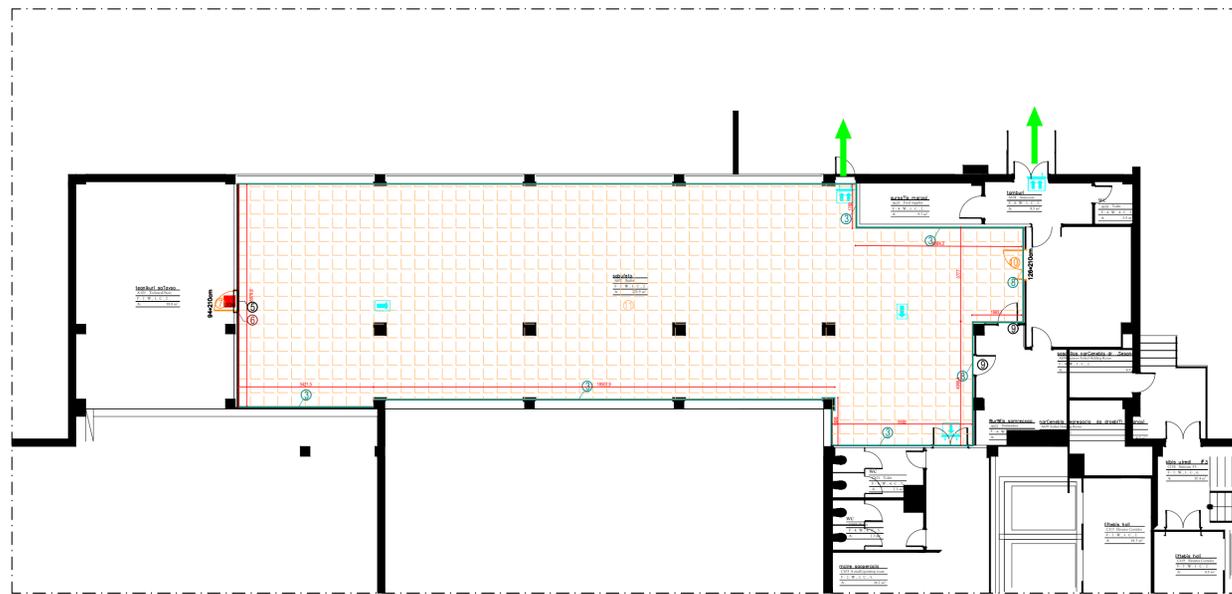

③ PHOTOGRAPHS OF CURRENT SITUATION –FIRST FLOOR MEDICAL SUPPLY ROOM #101-AR-001

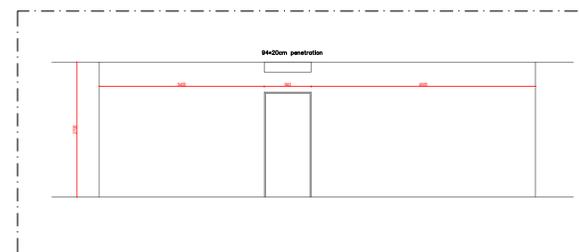


④ ELEVATION VIEW OF AHU ROOM – FIRST FLOOR MEDICAL SUPPLY ROOM #101-AR-001
1/50

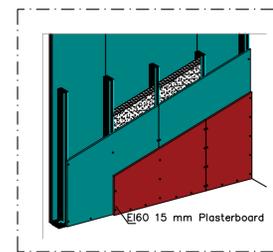

⑤ WALL DETAIL FOR FIRE SEPARATION EI60/

LEGEND AND MATERIAL LIST	
SYMBOL	DESCRIPTION
[Red Grid]	TO BE DEMOLISHED 60x60 GRID SUSPENDED CEILING
[Red Dotted]	TO BE MOUNTED 60x60 GRID SUSPENDED CEILING
[Red Horizontal Lines]	TO BE DEMOLISHED PVC HYDROXID SUSPENDED CEILING
[Red Vertical Lines]	TO BE MOUNTED PVC HYDROXID SUSPENDED CEILING
[Red Diagonal Lines]	TO BE DEMOLISHED PLASTERBOARD SUSPENDED CEILING
[Red Stippled]	TO BE MOUNTED PLASTERBOARD SUSPENDED CEILING
[Red Circle]	TO BE CLOSED HOLE BY IRIS WALL
[Red Square]	TO BE APPLIED FIRE STOPPING AT THE FLOOR LEVEL WITH ADDITIONAL SUPPORTING CONSTRUCTION
[Red Triangle]	TO BE DEMOLISHED EXISTING PLASTERBOARD WALL
[Red Diamond]	TO BE DEMOLISHED EXISTING GLASS PARTITION WALL
[Red Hexagon]	TO BE DEMOLISHED EXISTING CERAMIC TILE
[Red Octagon]	TO BE CONSTRUCTED PLASTERBOARD WALL WITHOUT FIRE RATING
[Red Circle with X]	TO BE CONSTRUCTED CERAMIC TILE
[Red Square with X]	TO BE CONSTRUCTED COMPARTMENT WALL FOR FIRE SEPARATION EI60- 2x12.5 mm /from both sides
[Red Triangle with X]	TO BE CONSTRUCTED SHUTT WALL FOR FIRE SEPARATION EI20 - Shell Wall 2x25 mm Plasterboard/From one side
[Red Diamond with X]	TO BE CONSTRUCTED WALL FOR FIRE SEPARATION EI20 - 2x15 mm/From both sides
[Red Hexagon with X]	TO BE CONSTRUCTED WALL FOR FIRE SEPARATION EI60 - 2x15 mm Plasterboard/From one side
[Red Octagon with X]	TO BE CONSTRUCTED PLASTERBOARD WALL -ABOVE THE EXISTING WALL
[Red Circle with X]	TO BE CONSTRUCTED PLASTERBOARD WALL FOR FIRE SEPARATION EI60 - One Layer
[Red Square with X]	TO BE CONSTRUCTED 25MM PLASTERBOARD WALL FOR FIRE SEPARATION EI20- One Layer
[Red Triangle with X]	TO BE CONSTRUCTED 15MM PLASTERBOARD WALL FOR FIRE SEPARATION EI20- One Layer
[Red Diamond with X]	TO BE APPLIED PLASTER
[Red Hexagon with X]	TO BE DEMOLISHED EXISTING DOOR
[Red Octagon with X]	TO BE MOUNTED NEW FIRE DOOR
[Red Circle with X]	TO BE REMOVED EXISTING DOOR

- FOR SYSTEM APPROVAL
- FOR TENDER
- FOR INSTALLATION
- AS BUILT

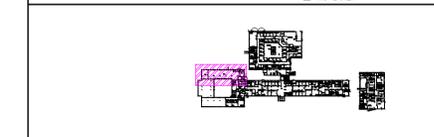

Date	For System Approval	Explanation

CLIENT: **EVEX HOSPITALS** / EVEX GEORGIA HEALTHCARE GROUP
 40 Nispetiye Sok. No: 37/4
 Tuzla - GEORJIA
 Tel: +995 322 55 05 05

DESIGNER: **KARINA** TASARIM, DANIŞMANLIK VE EĞİTİM HİZMETLERİ LTD.ŞTİ.
 06th EMEC Bulvarı 2. Cad. No : 37/4
 A. ÖZGÜLER - 06460 ANKARA / TÜRKİYE
 Tel : +90-312-472 62 88 Fax : +90-312-472 62 89 e-posta: info@karina.com.tr

TECH. CONSULTANCY : KARINA	FIRE & LIFE SAFETY-05 IMPROVEMENT OF FIRE & SMOKE CONFINEMENT FEATURES DRAWINGS
SYSTEM DESIGN : KARINA	
MATERIAL SUPPLY : -	
INSTALLATION : -	
APPROVAL : -	DRAWING NO : EVEX-DEKA-KAR-101-AR-001
DATE : 06.03.2021	
SCALE : 1/100	FILE NAME : C:\EVEX-DEKA-KAR-101-102-103-104-105*