

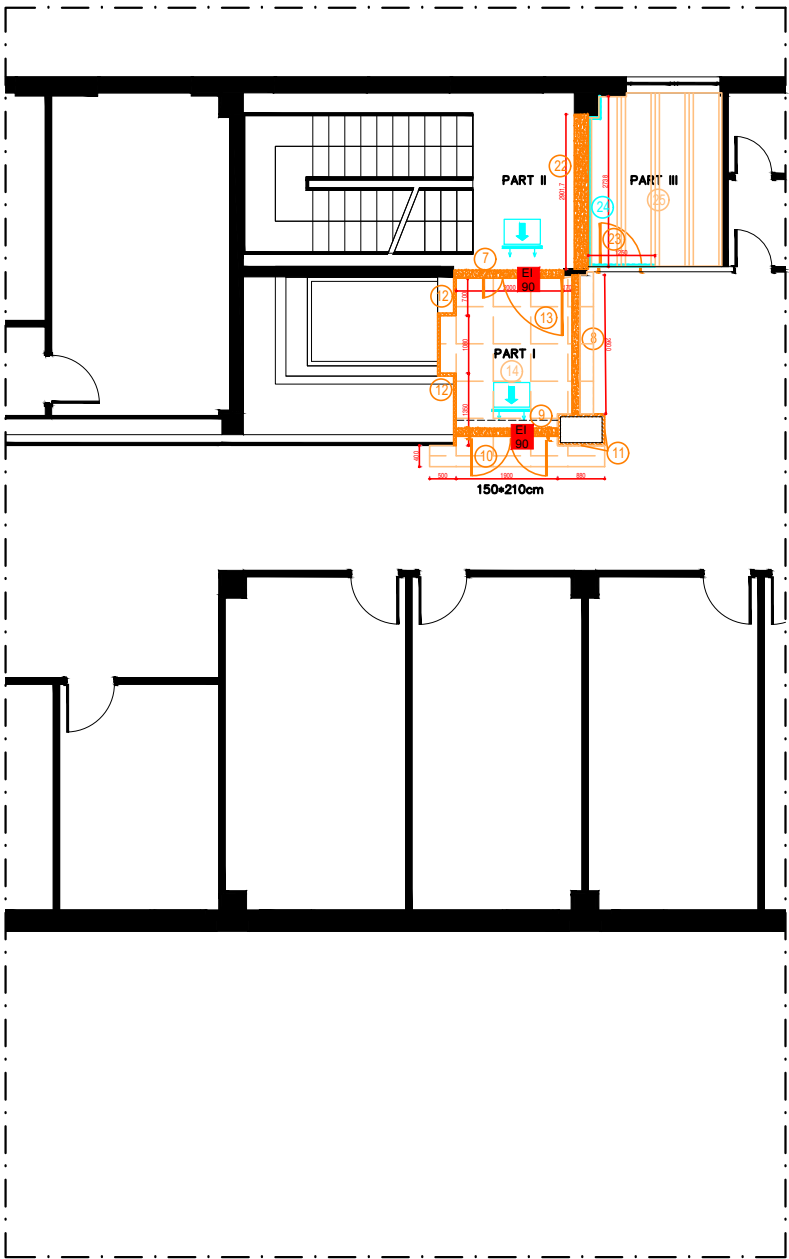
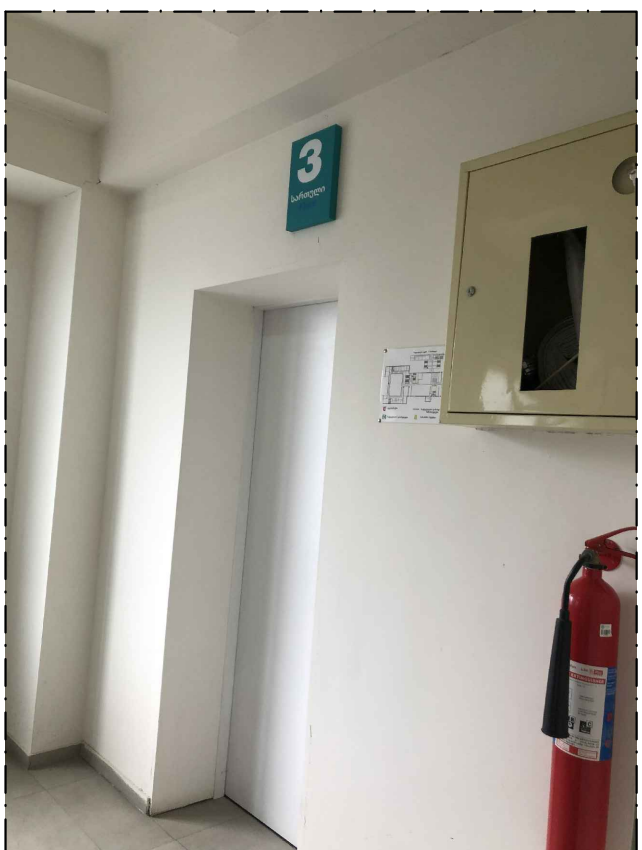



① DEMOLITION PLAN - THIRD FLOOR #304-AR-001
1/100

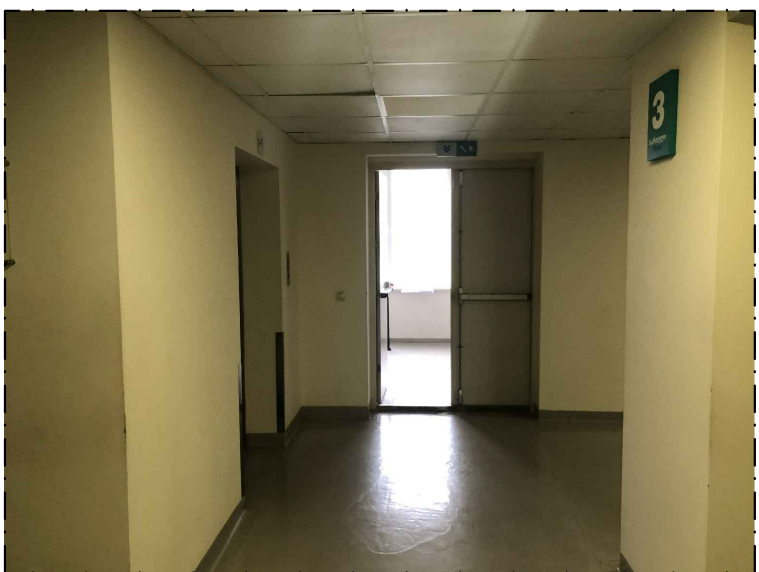


② NEW CONSTRUCTION PLAN - THIRD FLOOR #304-AR-001
1/100

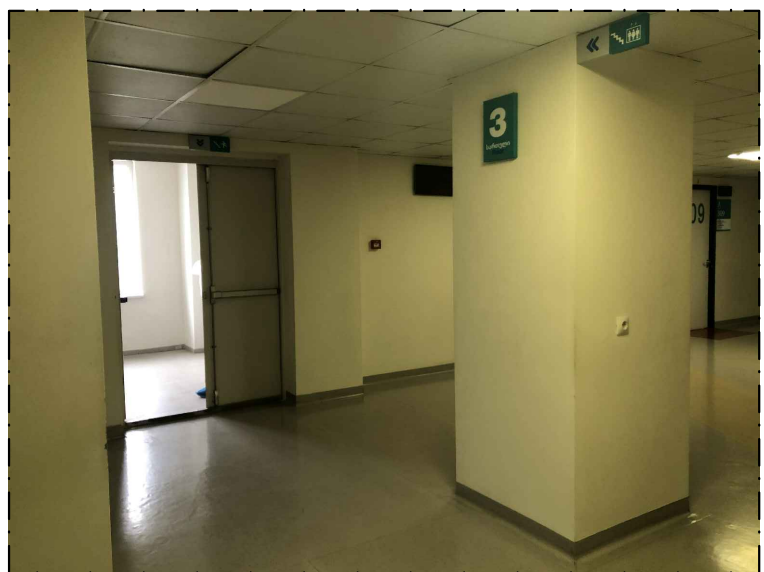


③ PHOTOGRAPHS OF CURRENT SITUATION - THIRD FLOOR #304-AR-001

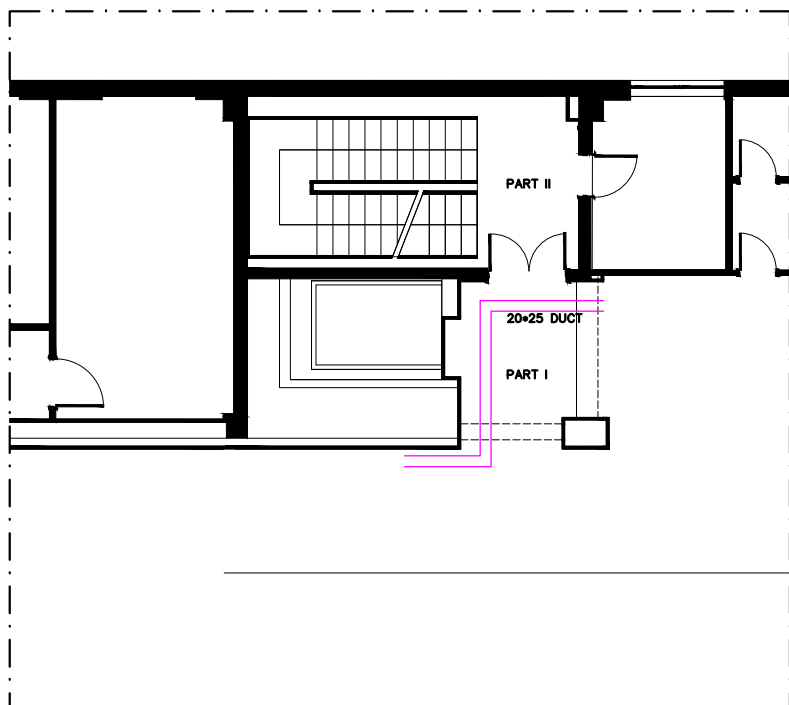


④ EXISTING DUCT - THIRD FLOOR #304-AR-001
1/100

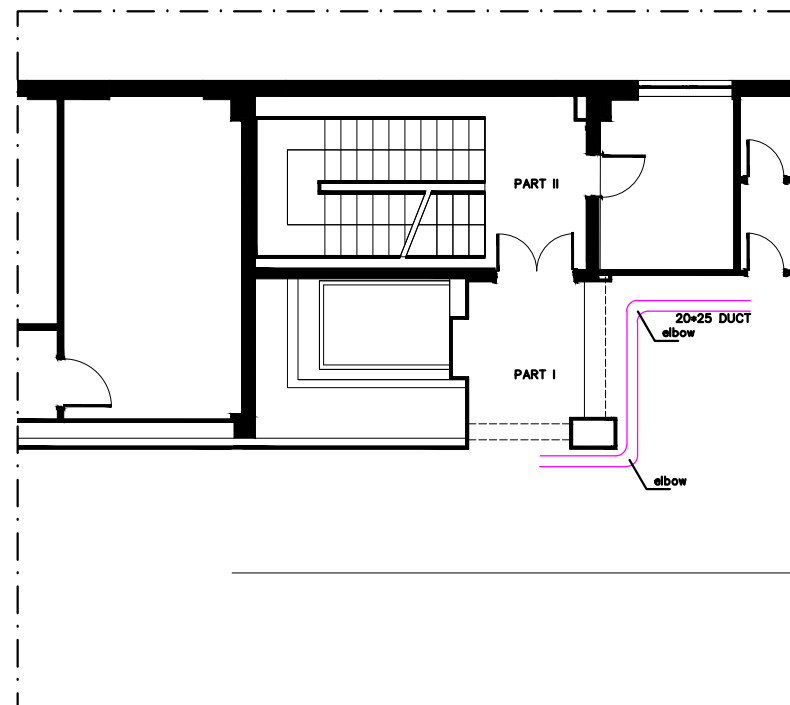

⑤ NEW LOCATION OF THE DUCT - THIRD FLOOR #304-AR-001
1/100

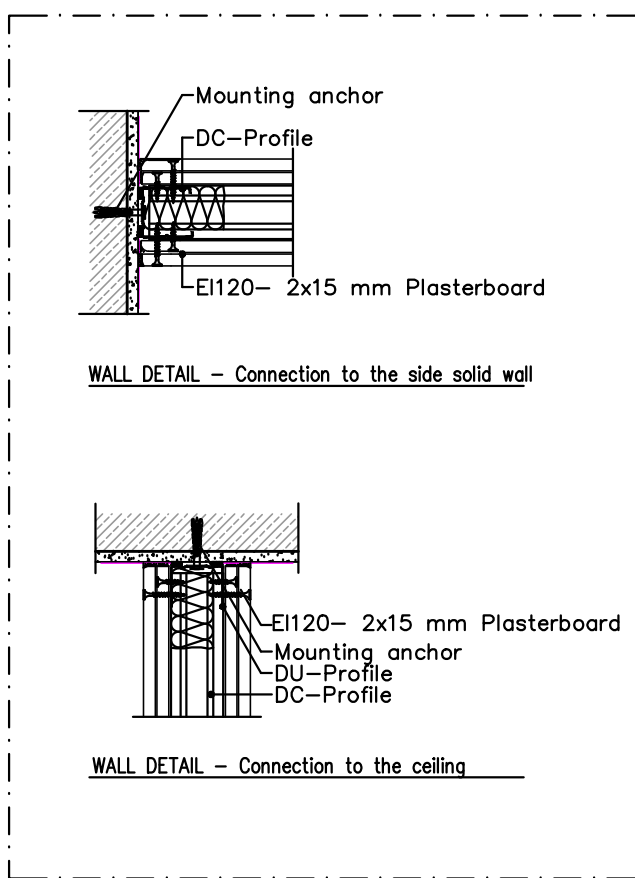

⑥ STAIRCASE WALL DETAIL FOR FIRE SEPARATION E120/from both sides

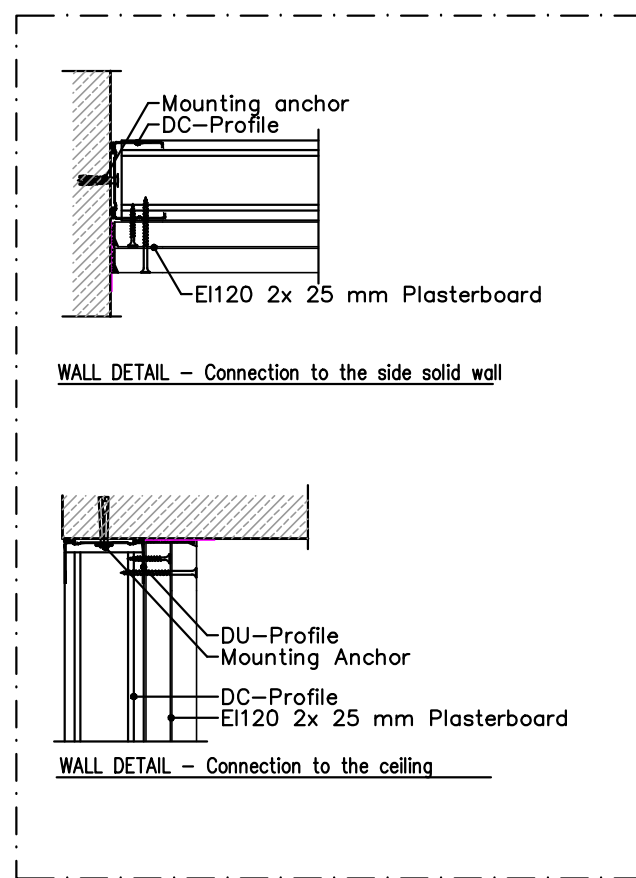

⑦ WALL DETAIL FOR FIRE SEPARATION E120/from one side

LEGEND AND MATERIAL LIST	
SYMBOL	DESCRIPTION
	TO BE DEMOLISHED 60x60 GRID SUSPENDED CEILING
	TO BE MOUNTED 60x60 GRID SUSPENDED CEILING
	TO BE DEMOLISHED PVC HYGIENIC SUSPENDED CEILING
	TO BE MOUNTED PVC HYGIENIC SUSPENDED CEILING
	TO BE DEMOLISHED PLASTERBOARD SUSPENDED CEILING
	TO BE MOUNTED PLASTERBOARD SUSPENDED CEILING
	TO BE CLOSED HOLE BY IRMS WALL
	TO BE APPLIED FIRE STOPPING AT THE FLOOR LEVEL WITH ADDITIONAL SUPPORTING CONSTRUCTION
	TO BE DEMOLISHED EXISTING PLASTERBOARD WALL
	TO BE DEMOLISHED EXISTING GLASS PARTITION WALL
	TO BE DEMOLISHED EXISTING CERAMIC TILE
	TO BE DEMOLISHED PLASTERBOARD WALL WITHOUT FIRE RATING
	TO BE DEMOLISHED CERAMIC TILE
	TO BE CONSTRUCTED COMPARTMENT WALL FOR FIRE SEPARATION E120 - 2x125 mm /from both sides
	TO BE CONSTRUCTED SHUTT WALL FOR FIRE SEPARATION E120 - Shaft Wall 2x25 mm Plasterboard/From one side
	TO BE CONSTRUCTED WALL FOR FIRE SEPARATION E120 - 2x15 mm /from both sides
	TO BE CONSTRUCTED WALL FOR FIRE SEPARATION E120 - 2x15 mm Plasterboard/From one side
	TO BE CONSTRUCTED PLASTERBOARD WALL -ABOVE THE EXISTING WALL
	TO BE CONSTRUCTED PLASTERBOARD WALL FOR FIRE SEPARATION E120 - One Layer
	TO BE CONSTRUCTED 25MM PLASTERBOARD WALL FOR FIRE SEPARATION E120- One Layer
	TO BE CONSTRUCTED 15MM PLASTERBOARD WALL FOR FIRE SEPARATION E120- One Layer
	TO BE APPLIED PLASTER
	TO BE DEMOLISHED EXISTING DOOR
	TO BE MOUNTED NEW FIRE DOOR
	TO BE REMOUNTED EXISTING DOOR

<input type="checkbox"/> FOR SYSTEM APPROVAL <input type="checkbox"/> FOR TENDER <input type="checkbox"/> FOR INSTALLATION <input type="checkbox"/> AS BUILT	
KEY PLAN	
Date	For System Approval
Explanation	
CLIENT	EVEEX GEORGIA HEALTHCARE GROUP
40 Vazha Pshavola Ave Tbilisi - GEORGIA Tel: +995 322 55 05 05	
DESIGNER	KARINA TASARIM, DANIŞMANLIK VE EĞİTİM HİZMETLERİ LTD.ŞTİ.
Cadd. EMEC Bulvarı 2. Cad. No : 37/4 A. ÖVEZLER - 06460 ANKARA / TÜRKİYE Tel : +90-312-472 62 88 Faks : +90-312-472 62 89 e-posta: info@karina.gen.tr	
TECH. CONSULTANCY	: KARINA
SYSTEM DESIGN	: KARINA
MATERIAL SUPPLY	: -
INSTALLATION	: -
APPROVAL	: -
DATE	: 06.03.2021
SCALE	: 1/100
DRAWING NO : EVEEX-DEKA-KAR-304-AR-001	
REV. 00	
FILE NAME : C:\EVEEX-DEKA-KAR-301-302-303-304-305-AR-	