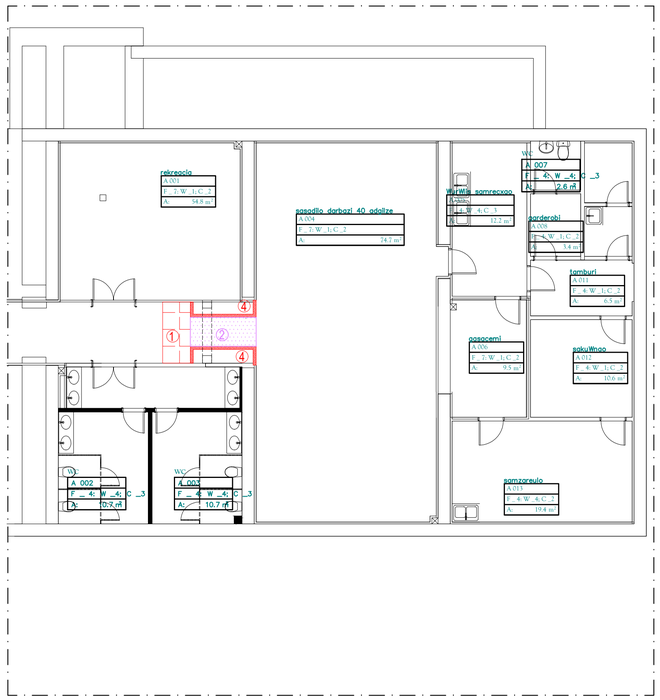

1 DEMOLITION PLAN – GROUND FLOOR #G05-AR-001
1/100

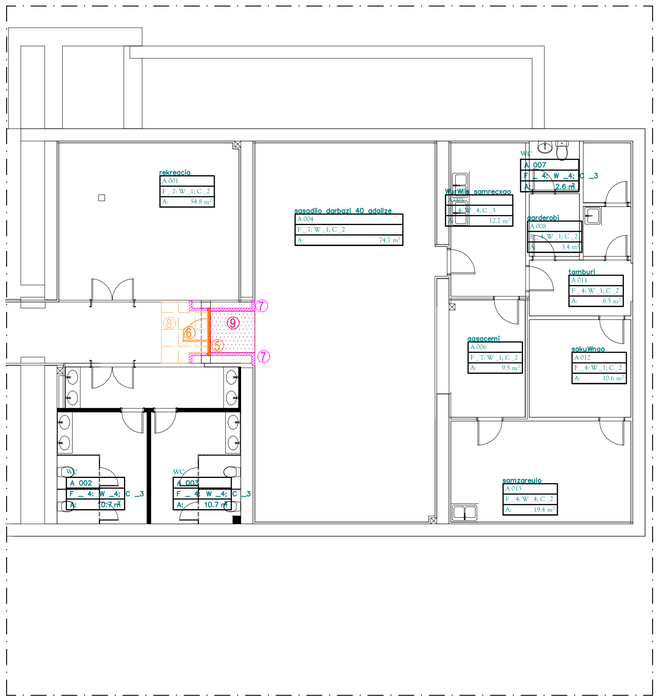

2 NEW CONSTRUCTION PLAN – GROUND FLOOR #G05-AR-001
1/100

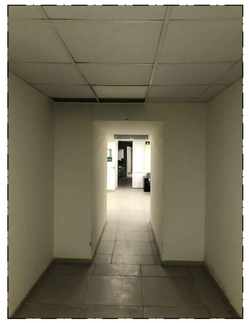

(Passsage to be demolished)

3 PHOTOGRAPHS OF CURRENT SITUATION – GROUND FLOOR #G04-AR-004

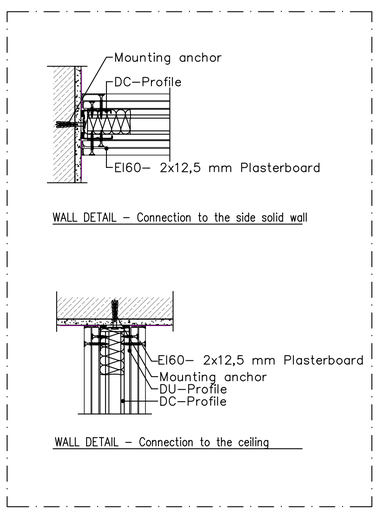

4 COMPARTMENT WALL DETAIL FOR FIRE SEPARATION EI60/from both sides

1. Demolition of grid suspended ceiling in the corridor– total 1.8m2
2. Demolition of plasterboard suspended ceiling in the corridor– total 1.9m2
3. Demolition of of the equipment on ceiling – 1 60*60 led lighting fixture
4. Demolition of plasterboard walls in the corridor –2X 275*280cm
5. Construction of EI60 compartment wall in the corridor –2*12.5mm manufactured from both sides, see wall detail. (155*280cm)
6. Provide a new EI45 fire door (140*210cm)
7. Construction of new plasterboards instead of dismantled ones
8. Mounting of new grid suspended ceiling– total 1.8m2
9. Mounting new plasterboard suspended ceiling– total 1.9m2
10. Reassembling of equipment on the ceiling

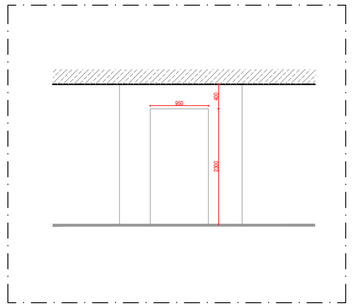

5 ELEVATION VIEW
1/50

LEGEND AND MATERIAL LIST

SYMBOL	DESCRIPTON
	TO BE DEMOLISHED 60×60 GRID SUSPENDED CEILING
	TO BE MOUNTED 60×60 GRID SUSPENDED CEILING
	TO BE DEMOLISHED PVC HYCENIZC SUSPENDED CEILING
	TO BE MOUNTED PVC HYCENIZC SUSPENDED CEILING
	TO BE DEMOLISHED PLASTERBOARD SUSPENDED CEILING
	TO BE MOUNTED PLASTERBOARD SUSPENDED CEILING
	TO BE CLOSED HOLE BY BMS WALL
	TO BE DEMOLISHED EXISTING PLASTERBOARD WALL
	TO BE DEMOLISHED EXISTING CERAMIC TILE
	TO BE CONSTRUCTED PLASTERBOARD WALL WITHOUT FIRE RATING
	TO BE CONSTRUCTED CERAMIC TILE
	TO BE CONSTRUCTED COMPARTMENT WALL FOR FIRE SEPARATION EI60– 2x12,5 mm /from both sides
	TO BE CONSTRUCTED SHAFT WALL FOR FIRE SEPARATION EI120 – Shaft Wall 2x25 mm Flameboard/from one side
	TO BE CONSTRUCTED WALL FOR FIRE SEPARATION EI120 – 2x15 mm/from both sides
	TO BE CONSTRUCTED WALL FOR FIRE SEPARATION EI60 – 2x15 mm Plasterboard/from one side
	TO BE CONSTRUCTED HALL WALL FOR FIRE SEPARATION EI60 – One Layer
M	TO BE DEMOLISHED EXISTING DOOR
M	TO BE MOUNTED NEW FIRE DOOR
M	TO BE REMOUNTED EXISTING DOOR

- [■] FOR SYSTEM APPROVAL
- [ ] FOR TENDER
- [ ] FOR INSTALLATION
- [ ] AS BUILT

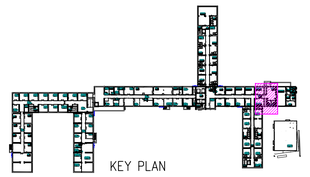

		For System Approval
	Date	Explanation

CLIENT

EVEX HOSPITALS

DESIGNER KARİNA TASARIM, DANIŞMANLIK VE EĞİTİM HİZMETLERİ LTD.ŞTİ.
Çetin EMEÇ Bulvarı 2. Cad. No : 37/4
A. ÖVEÇLER – 06460 ANKARA / TURKEY
Tel : +90-312-472 62 88 Faks : +90-312-472 62 89 e-posta: info@karina.gen.tr

TECH. CONSULTANCY	: KARİNA
SYSTEM DESIGN	: KARİNA
MATERIAL SUPPLY	: -
INSTALLATION	: -
APPROVAL	: -
DATE	: 08.11.2020
SCALE	: 1/100

FIRE & LIFE SAFETY
IMPROVEMENT OF FIRE& SMOKE
COMPARTMENT FEATURES DRAWINGS

CAD

DRAWING NO : EVEX-SNS-KAR-G05-AR-001

REV. 00

FILE NAME : C:\EVEX-SNS-KAR-G04-G05-G06-G07-AR*

EVEX-SNS-KAR-G04-G05-G06-G07-AR

THIS DOCUMENT IS PROPERTY OF KARİNA AND SHALL NOT BE USED FOR ANY PURPOSE OTHER THAN THAT FOR WHICH IT WAS SUPPLIED, NOR REPRODUCED, COPIED OR DISCLOSED TO ANY THIRD PARTY WITHOUT PRIOR WRITTEN CONSENT.